




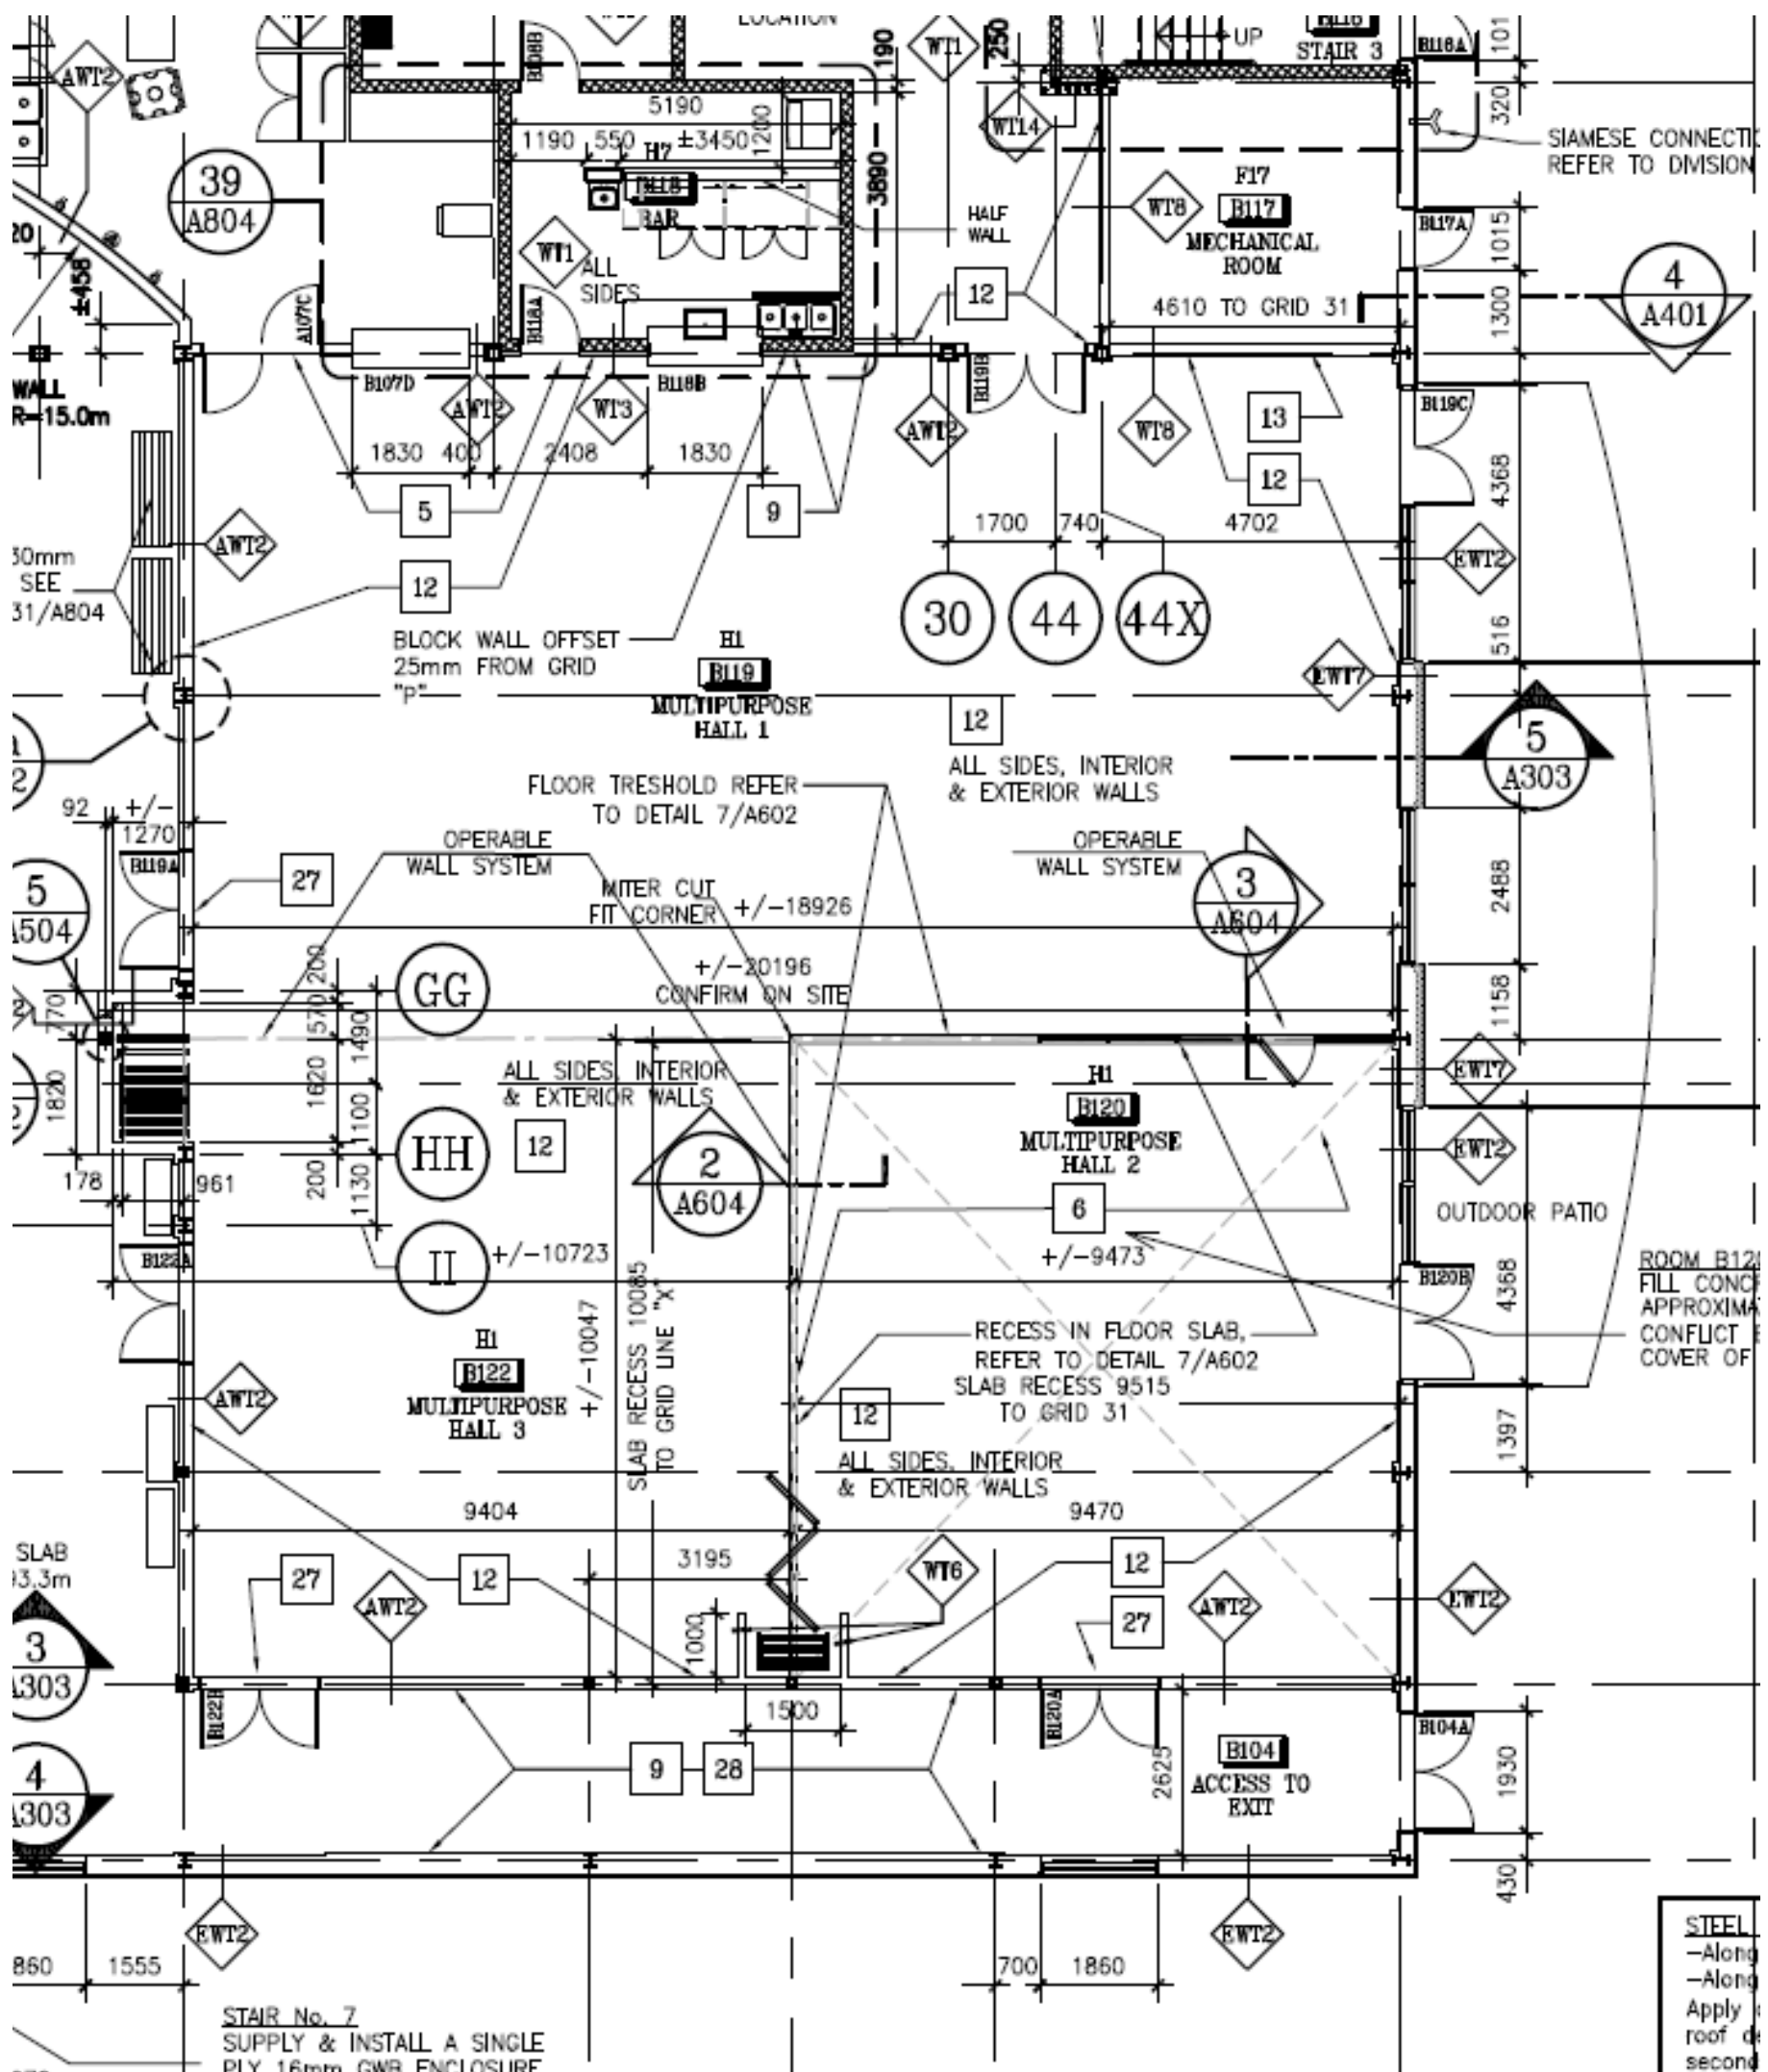

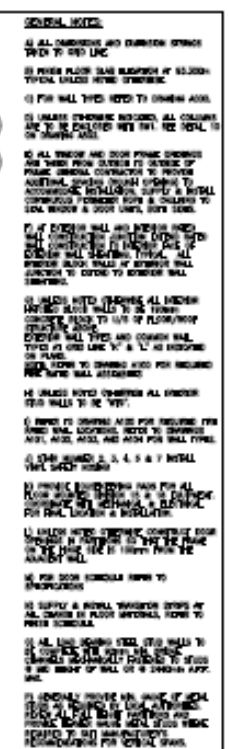

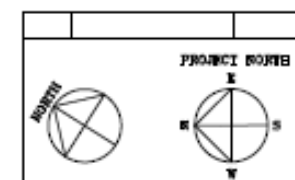

THE BASIS OF THE RECORD DRAWING, REFLECTING THE SIGNIFICANT CHANGES IN THE WORK SINCE DURING CONSTRUCTION, ARE BASED ON DATA FROM ARCHITECT'S CHANGE ORDERS AND SITE INSTRUCTIONS.

THE ISSUE OF THIS RECORD DRAWING IS A REPRODUCTION, BY THE ARCHITECT, THAT THE CONSTRUCTION OF THE BUILDING IS IN GENERAL AS OPPOSED TO PRECISE CONFORMITY WITH THE DESIGN PROVIDED BY THE ARCHITECT."

01	RECORD DIVERSITY	JULY 2020
SERIAL		date

emaARCHITECTSinc

200-162 cleopatra drive
newport ontario K2G 9X2
tel. 613 224 0095
fax 613 224 9911
www.cmcsmiles.com

project

**NORTH GRENVILLE
COMMUNITY COMPLEX**

	seal
--	------

drawing title OFFICE BUILDING GROUND FLOOR PLAN	
scale 1/8" = 1'-0"	drawn by CH. BA.
date 04 NOV 88	checked by EC
project number 03-389	drawing number A103

CONTRACTOR TO NOTIFY ALL UNDERSIGNS AND NOTIFY THE ARCHITECT OF ANY EXCHANGES BEFORE WORK COMMENCES. DO NOT SCALE DRAWING.	revision.
---	-----------